


 HVAC
 ELEC
 TECH
 PLUMBING
 FIRE



IMEG MARKUP LEGEND:

- HVAC
- ELEC
- TECH
- PLUMBING
- FIRE

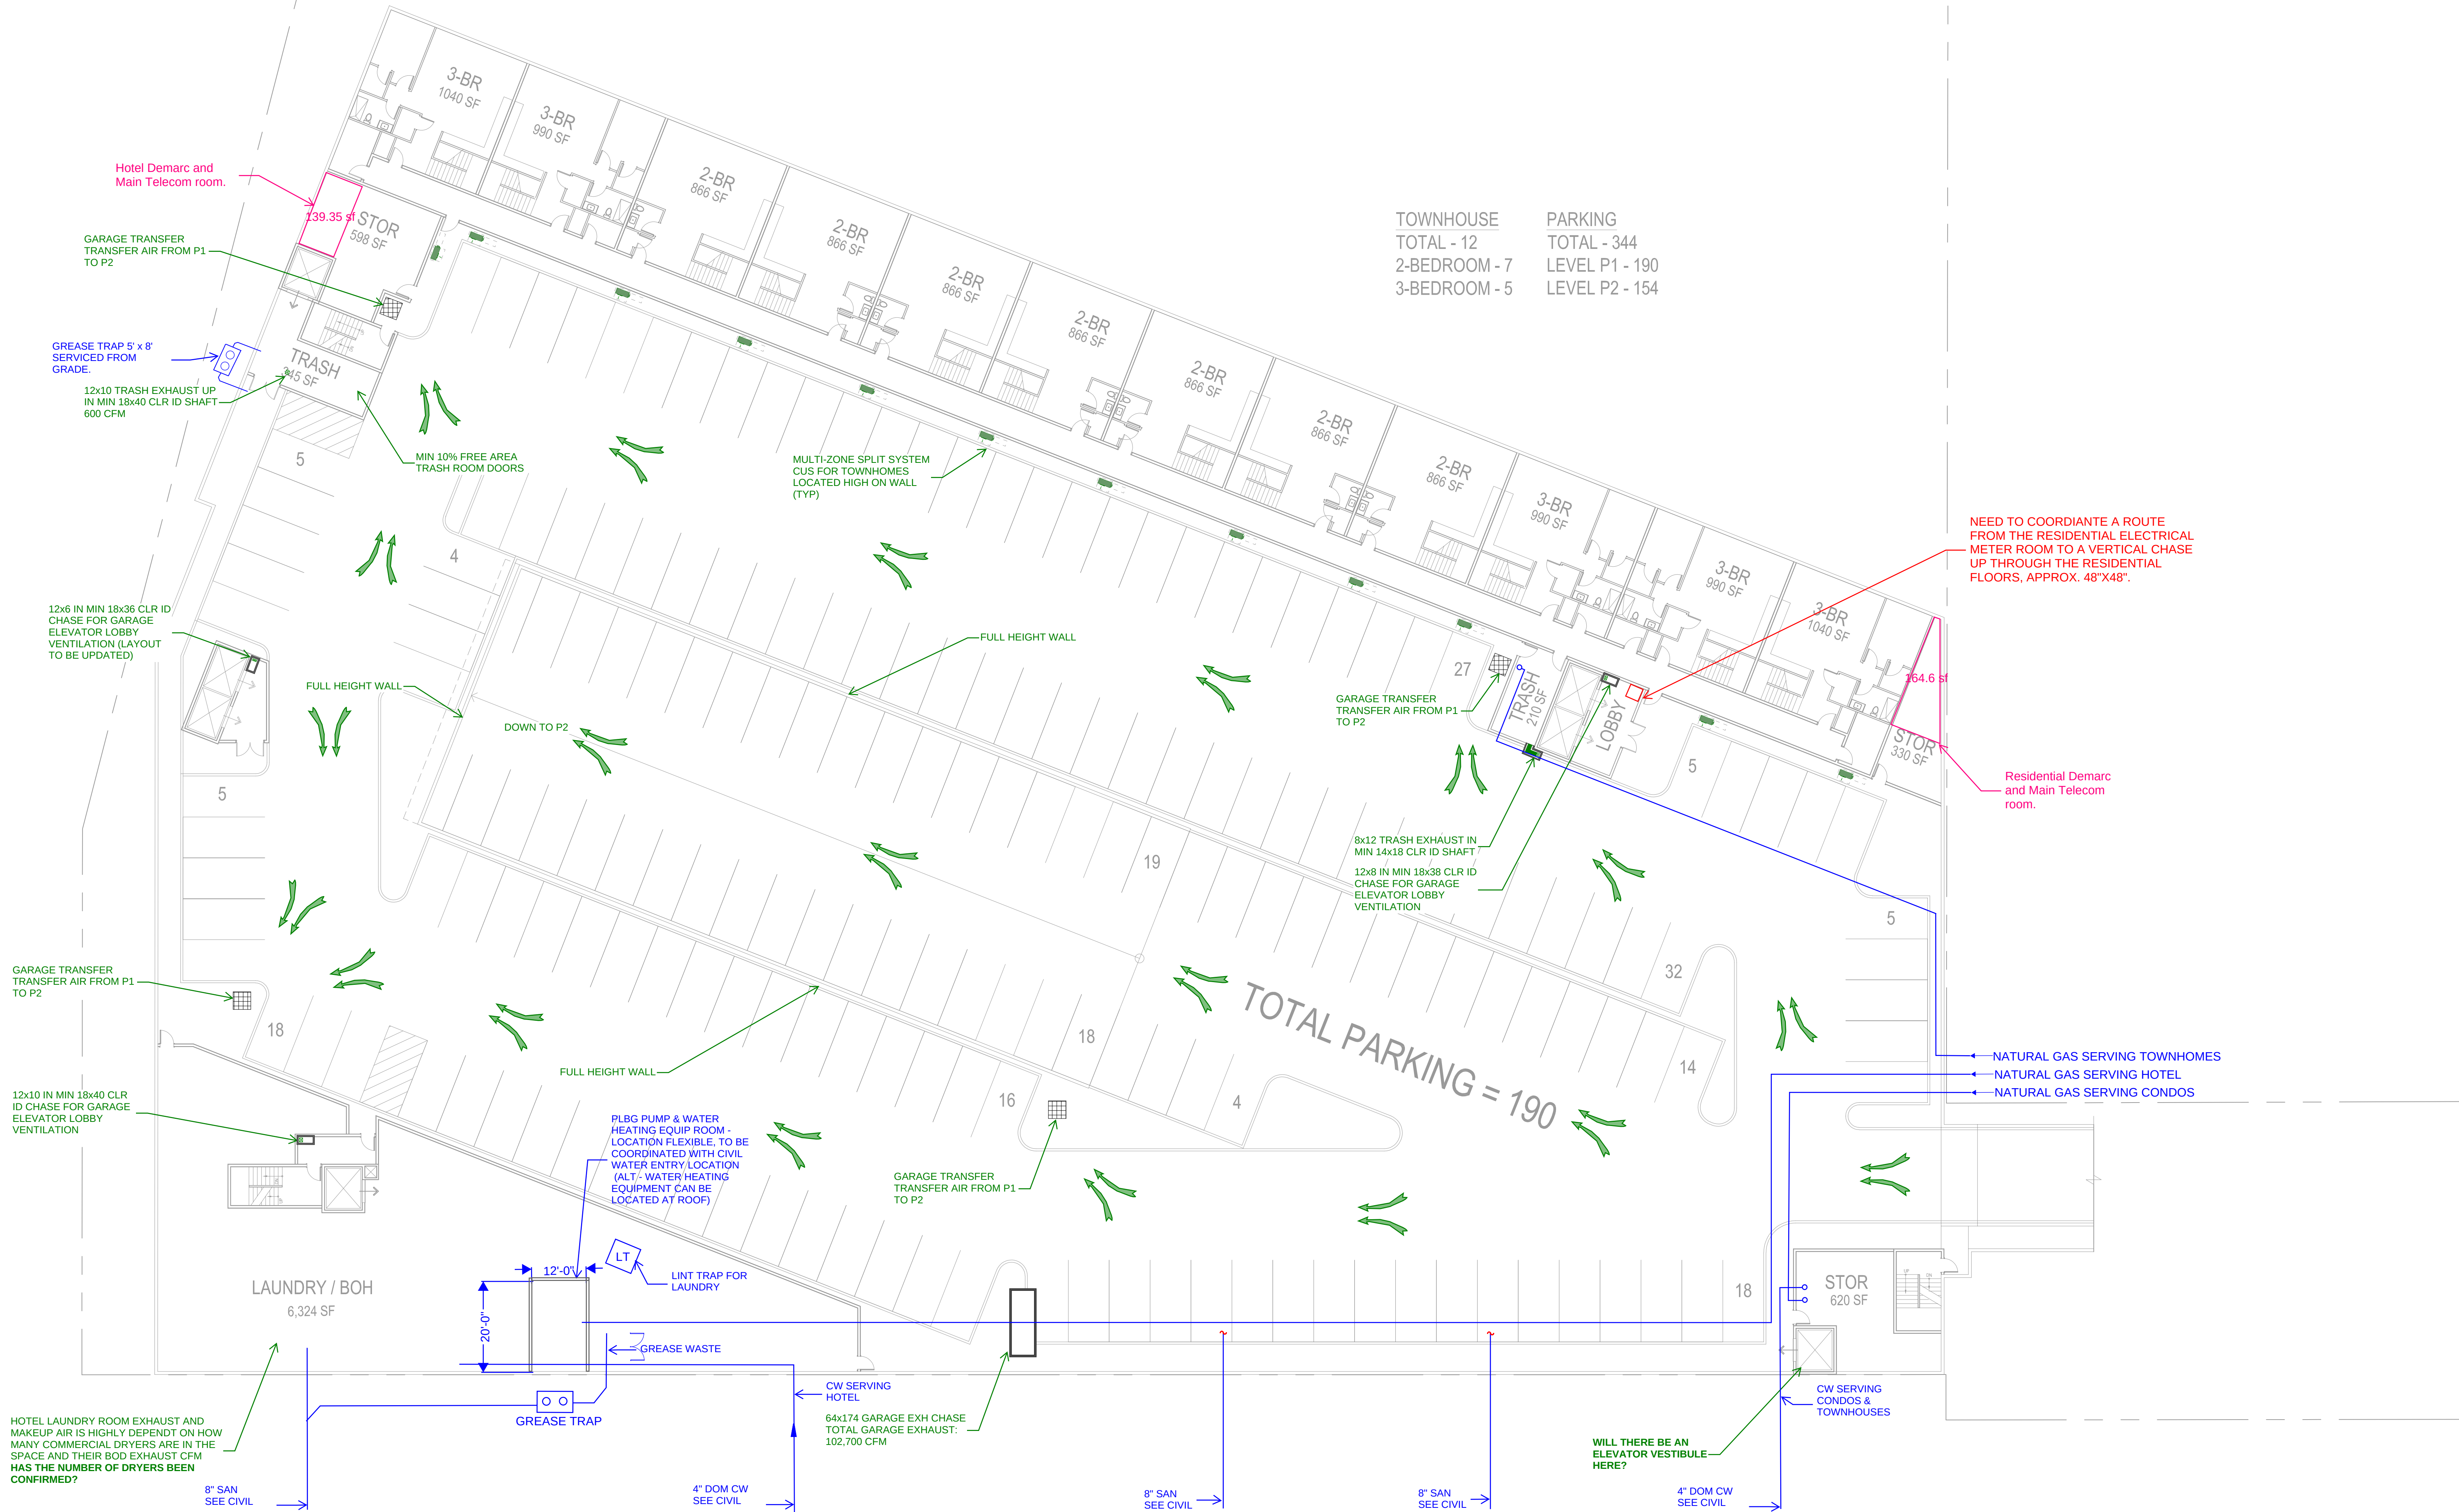

LEVEL P1 - GARAGE

IMEG MARKUP LEGEND:


- HVAC
- ELEC
- TECH
- PLUMBING
- FIRE

SD SET SPACE
COORDINATION

3/13/2026

HOTEL PROGRAM			
LEVEL 1		LEVEL P1 & P2	
LOBBY/LOUNGE:	2,406 SF	LAUNDRY/BOH:	6,324 SF
OFFICE:	565 SF		
CONFERENCE:	2,928 SF	LEVEL 4	
MEETING ROOM:	614 SF	RESTAURANT:	1,636 SF
PRE-FUNCTION:	1,307 SF	BAR:	519 SF
RESTAURANT:	3,562 SF	KITCHEN:	487 SF
BAR/SEATING:	1,094 SF		
KITCHEN/STOR:	1,484 SF		
FITNESS:	1,109 SF		
BOH/SUPPORT:	945 SF		
TRASH/LOADING:	1,401 SF		
RETAIL:	6,856 SF		

PROJECT DATA			
HOTEL:		CONDO:	
LEVEL 1:	29,433 SF	LEVEL 1:	23,602 SF
LEVEL 2:	26,949 SF	LEVEL 2:	23,405 SF
LEVEL 3:	26,949 SF	LEVEL 3:	23,405 SF
LEVEL 4:	26,949 SF	LEVEL 4:	23,405 SF
TOTAL:	110,280 SF	TOTAL:	93,817 SF
GARAGE/TOWNHOME:			
LEVEL P2:	82,099 SF		
LEVEL P1:	92,035 SF		
TOTAL:	174,134 SF		

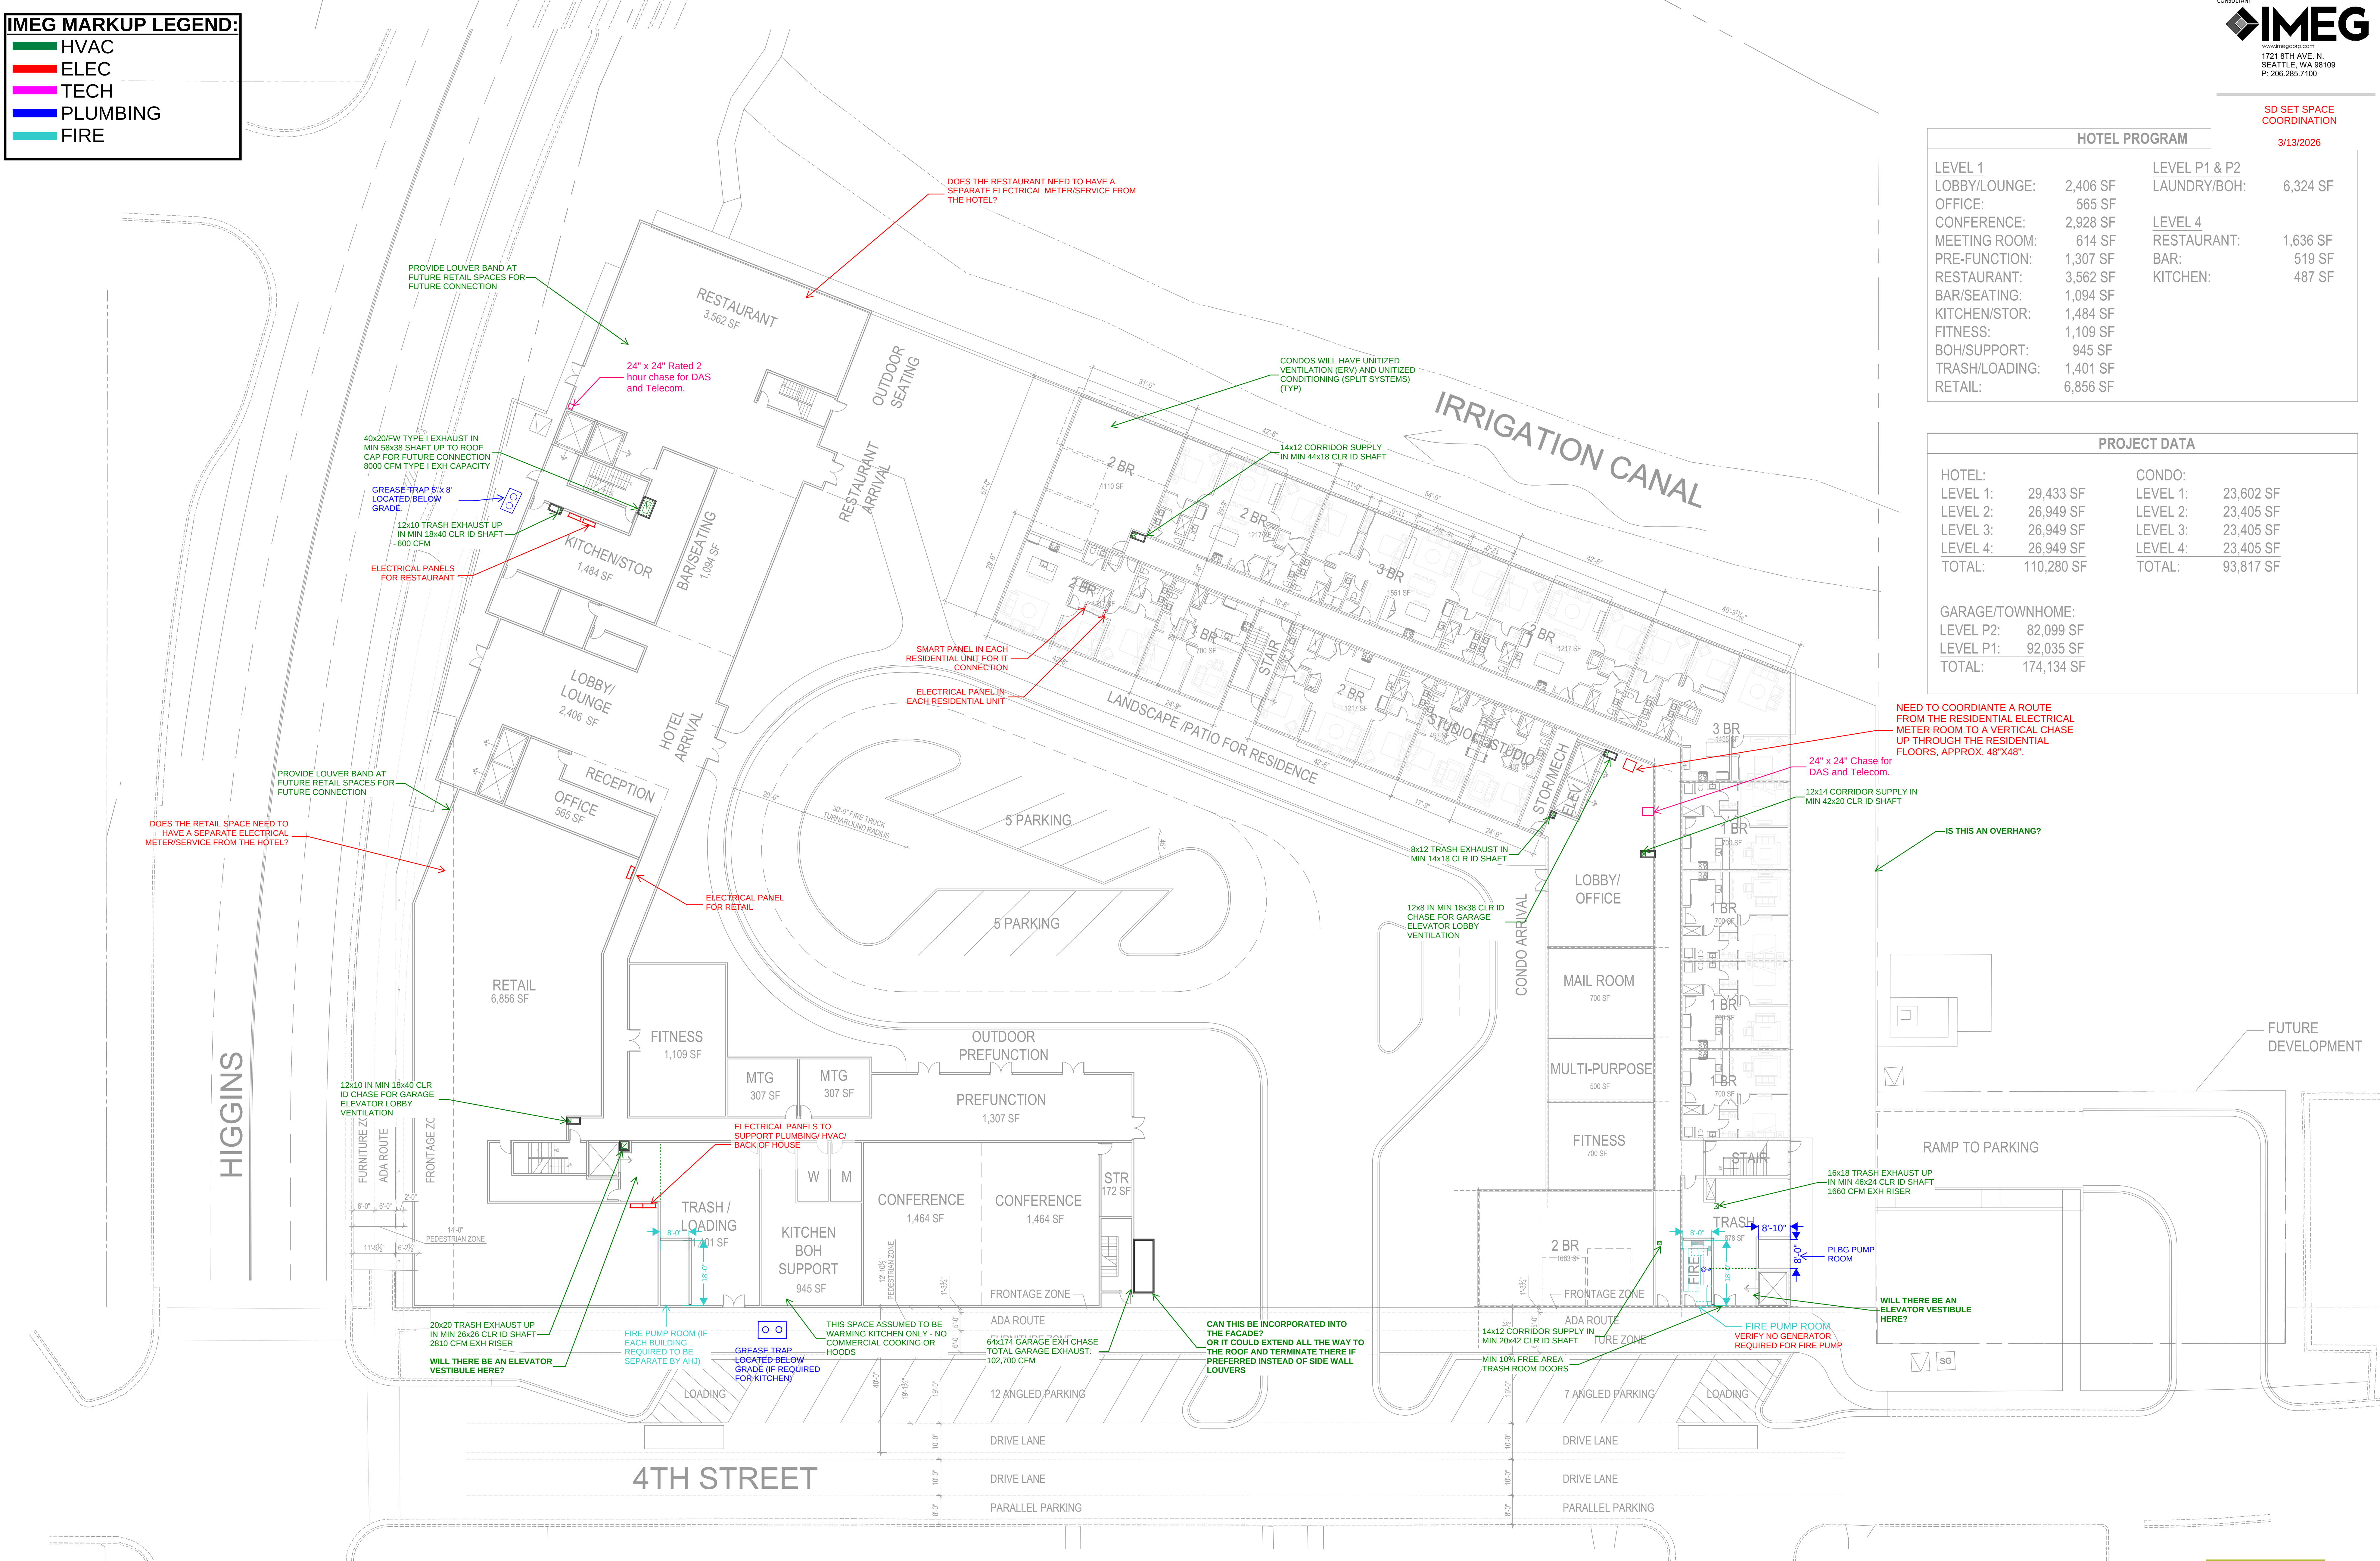

LEVEL 1

HIGGINS WATERFRONT

SCALE: 1/16" = 1'-0"

MISSOULA, MT

JENSEN DAVENPORT ARCHITECTS, INC.
architecture | planning | interior design
14421 Woodinville Redmond Rd NE, Woodinville, WA 98072



02.13.2026

IMEG MARKUP LEGEND:

- HVAC
- ELEC
- TECH
- PLUMBING
- FIRE

ROOM TYPE	LEVELS			TOTAL
	2	3	4	
SINGLE KING	33	33	33	99
DOUBLE QUEEN	18	18	13	49
SUITE	2	2	0	4
JR SUITE	3	3	3	9
TOTAL	56	56	49	161

TOTAL FLOOR SF = 26,949 SF

# OF	LEVELS				TOTAL
	1	2	3	4	
BEDROOM	1	2	3	4	
STUDIO	2	0	0	0	2
1 BEDROOM	5	7	7	0	19
2 BEDROOM	6	9	9	5	29
3 BEDROOM	2	2	2	3	9
3 BED + DEN	0	0	0	2	2
4 BEDROOM	0	0	0	2	2
TOTAL	15	18	18	12	63



LEVEL 2-3

HIGGINS WATERFRONT

SCALE: 1/16" = 1'-0"

MISSOULA, MT

JENSEN DAVENPORT ARCHITECTS, INC.
architecture | planning | interior design
14421 Woodinville Redmond Rd NE, Woodinville, WA 98072




02.13.2026

IMEG MARKUP LEGEND:

- HVAC
- ELEC
- TECH
- PLUMBING
- FIRE

GUESTROOM MATRIX				
ROOM TYPE	LEVELS			TOTAL
	2	3	4	
SINGLE KING	33	33	33	99
DOUBLE QUEEN	18	18	13	49
SUITE	2	2	0	4
JR SUITE	3	3	3	9
TOTAL	56	56	49	161

TOTAL FLOOR SF = 26,949 SF

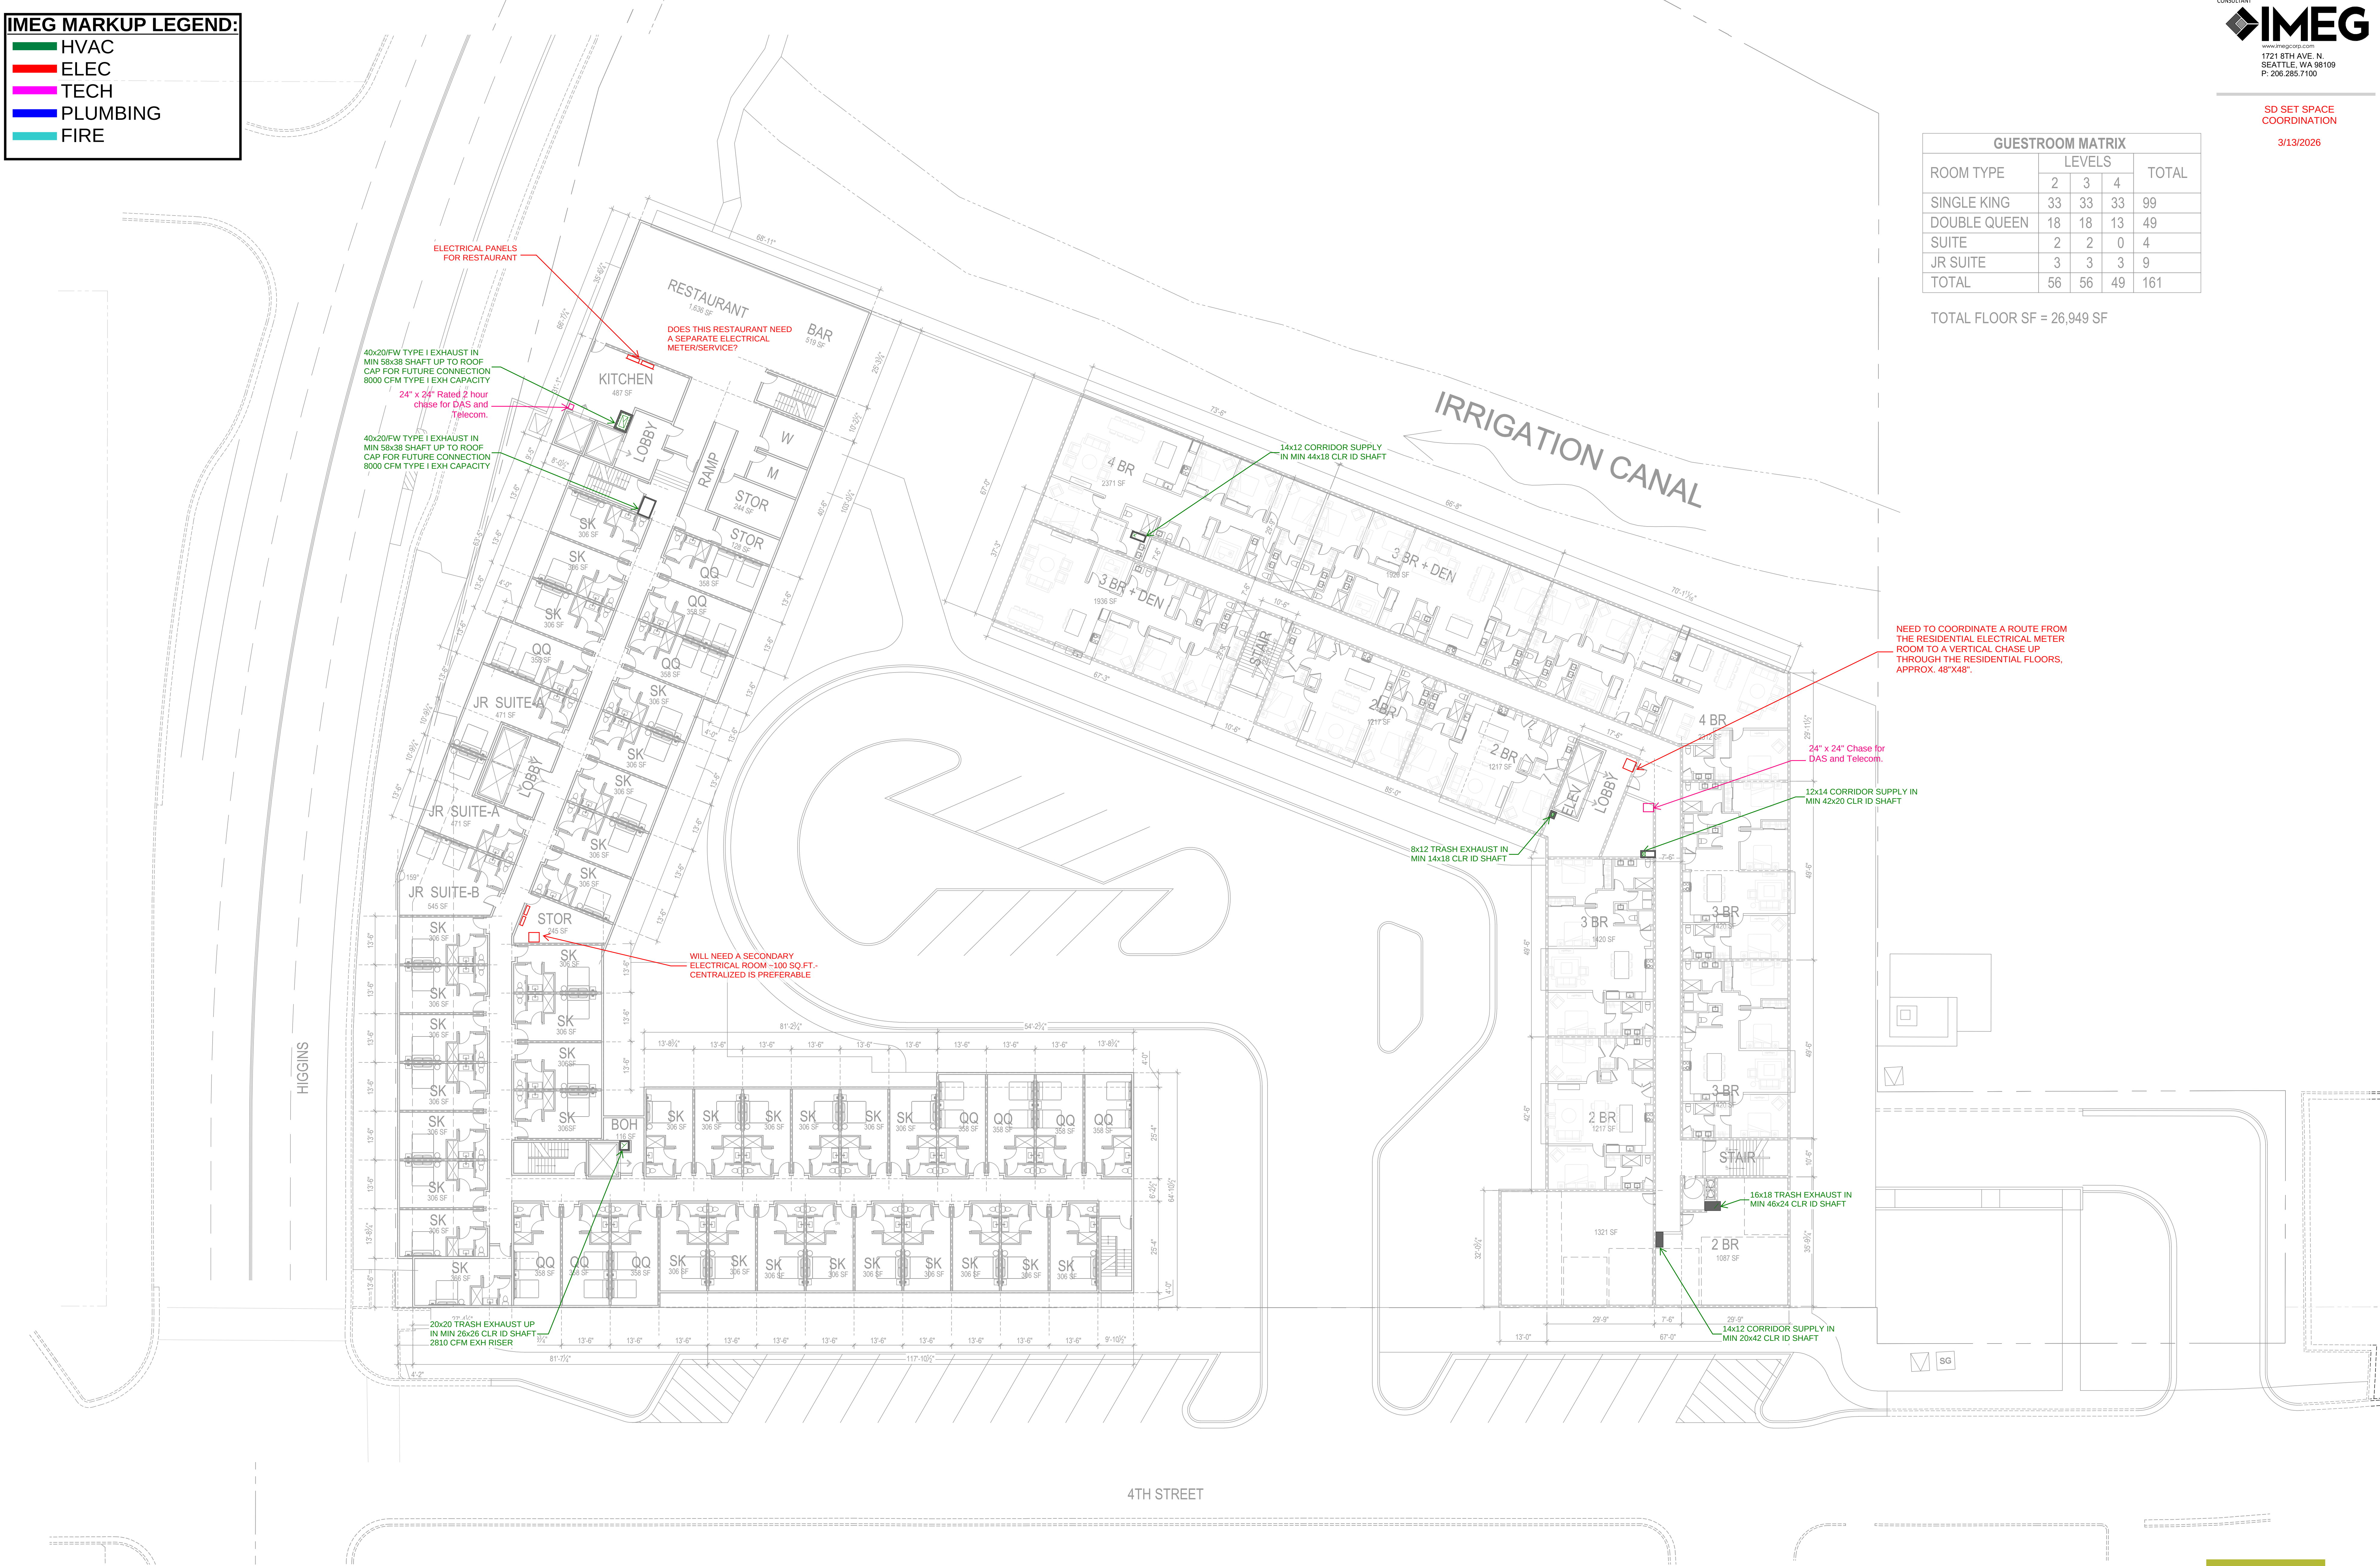

LEVEL 4

HIGGINS WATERFRONT

SCALE: 1/16" = 1'-0"

MISSOULA, MT


JENSEN DAVENPORT ARCHITECTS, INC.
architecture | planning | interior design
14421 Woodinville Redmond Rd NE, Woodinville, WA 98072



02.13.2026

IMEG MARKUP LEGEND:

- HVAC
- ELEC
- TECH
- PLUMBING
- FIRE

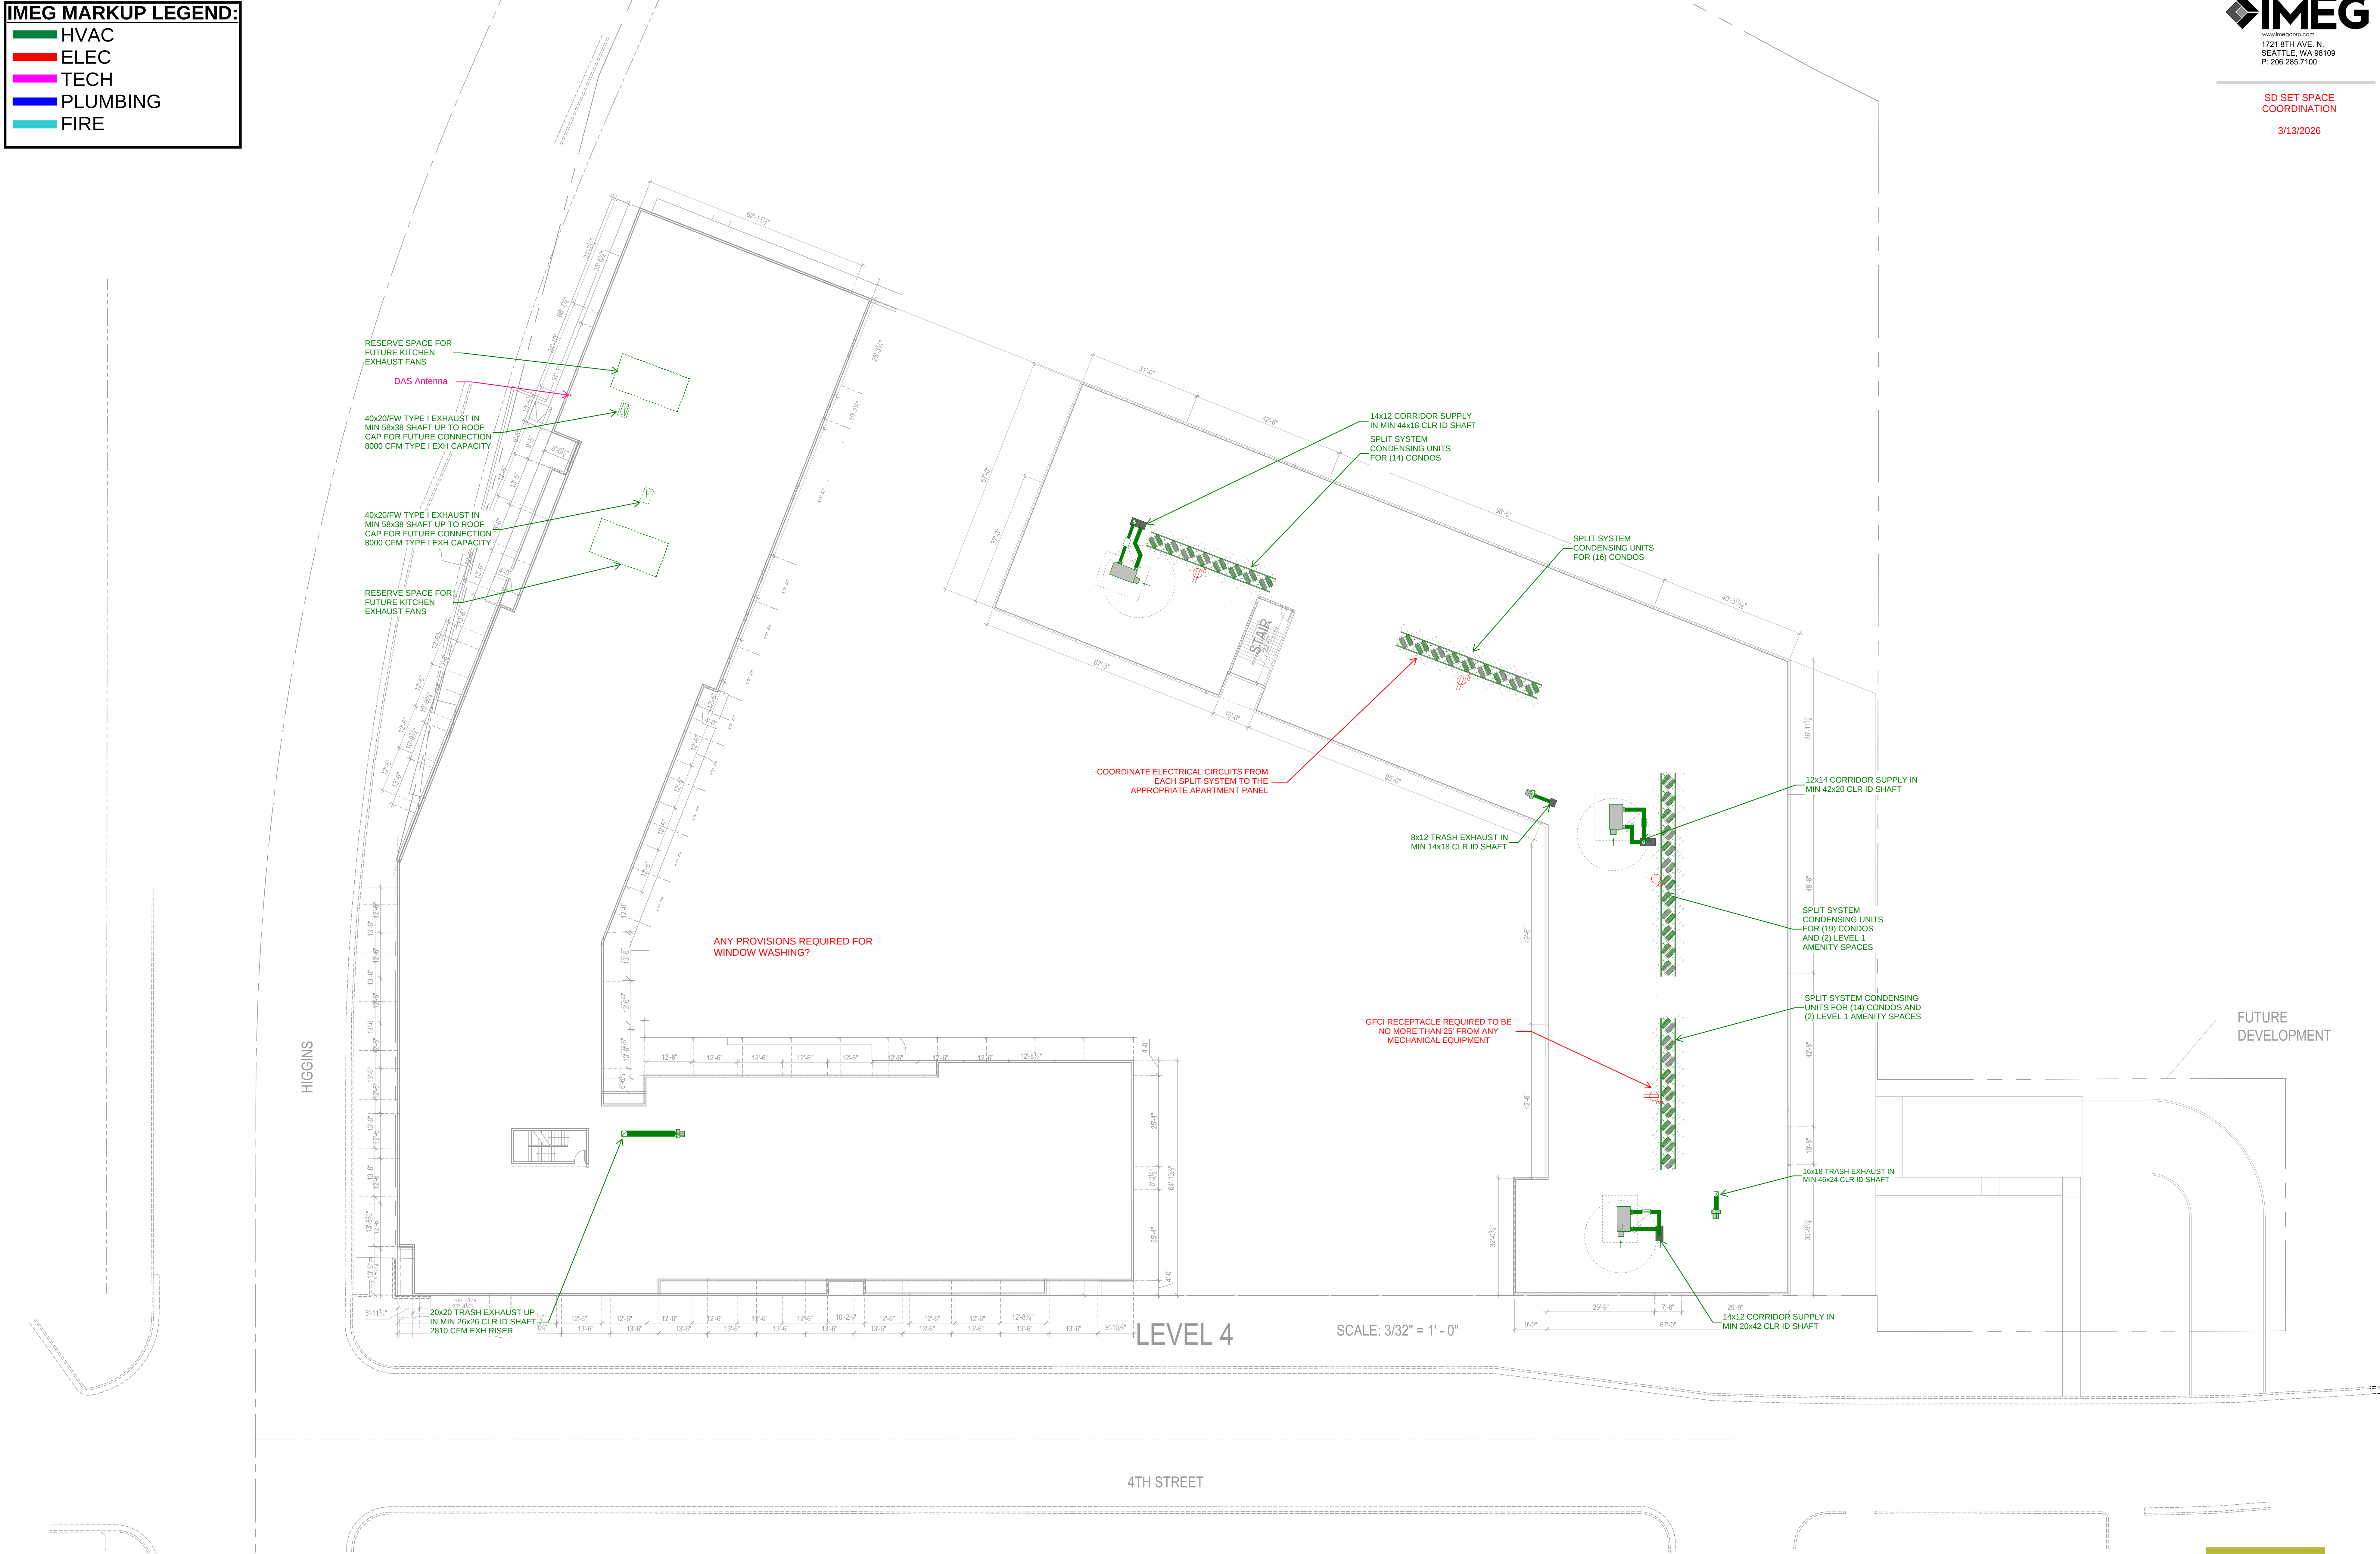

ROOF

HIGGINS WATERFRONT

SCALE: 1/16" = 1'-0"

MISSOULA, MT

JENSEN DAVENPORT ARCHITECTS, INC.
architecture | planning | interior design
14421 Woodinville Redmond Rd NE, Woodinville, WA 98072




02.13.2026



SD SET SPACE COORDINATION

3/13/2026

ERV AND ASSOCIATED DUCTWORK
LOCATED IN-JOIST
MIN 11-7/8" JOISTS REQUIRED

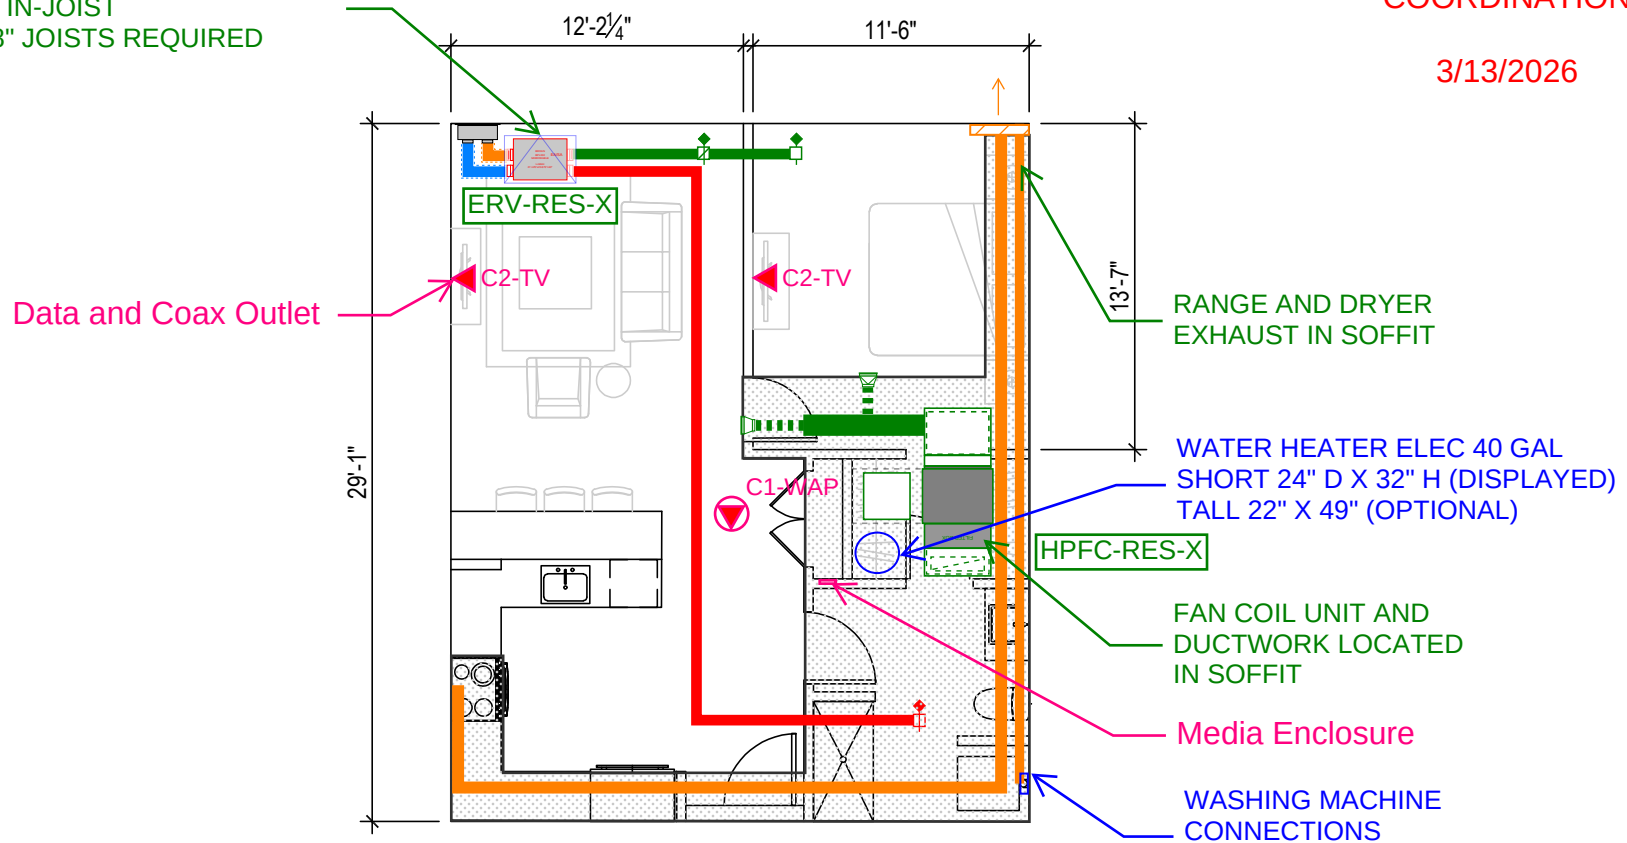

CONDO TYPICAL 1-BEDROOM

SCALE = 1/8" = 1'-0"

HVAC DUCTWORK LEGEND:


—	SUPPLY DUCT
—	ERV BATHROOM EXHAUST
—	ENVIRONMENTAL EXHAUST
—	INSULATED ERV OA INTAKE
—	INSULATED ERV EXHAUST



ERV AND ASSOCIATED DUCTWORK
LOCATED IN-JOIST
MIN 11-7/8" JOISTS REQUIRED

SD SET SPACE
COORDINATION

3/13/2026

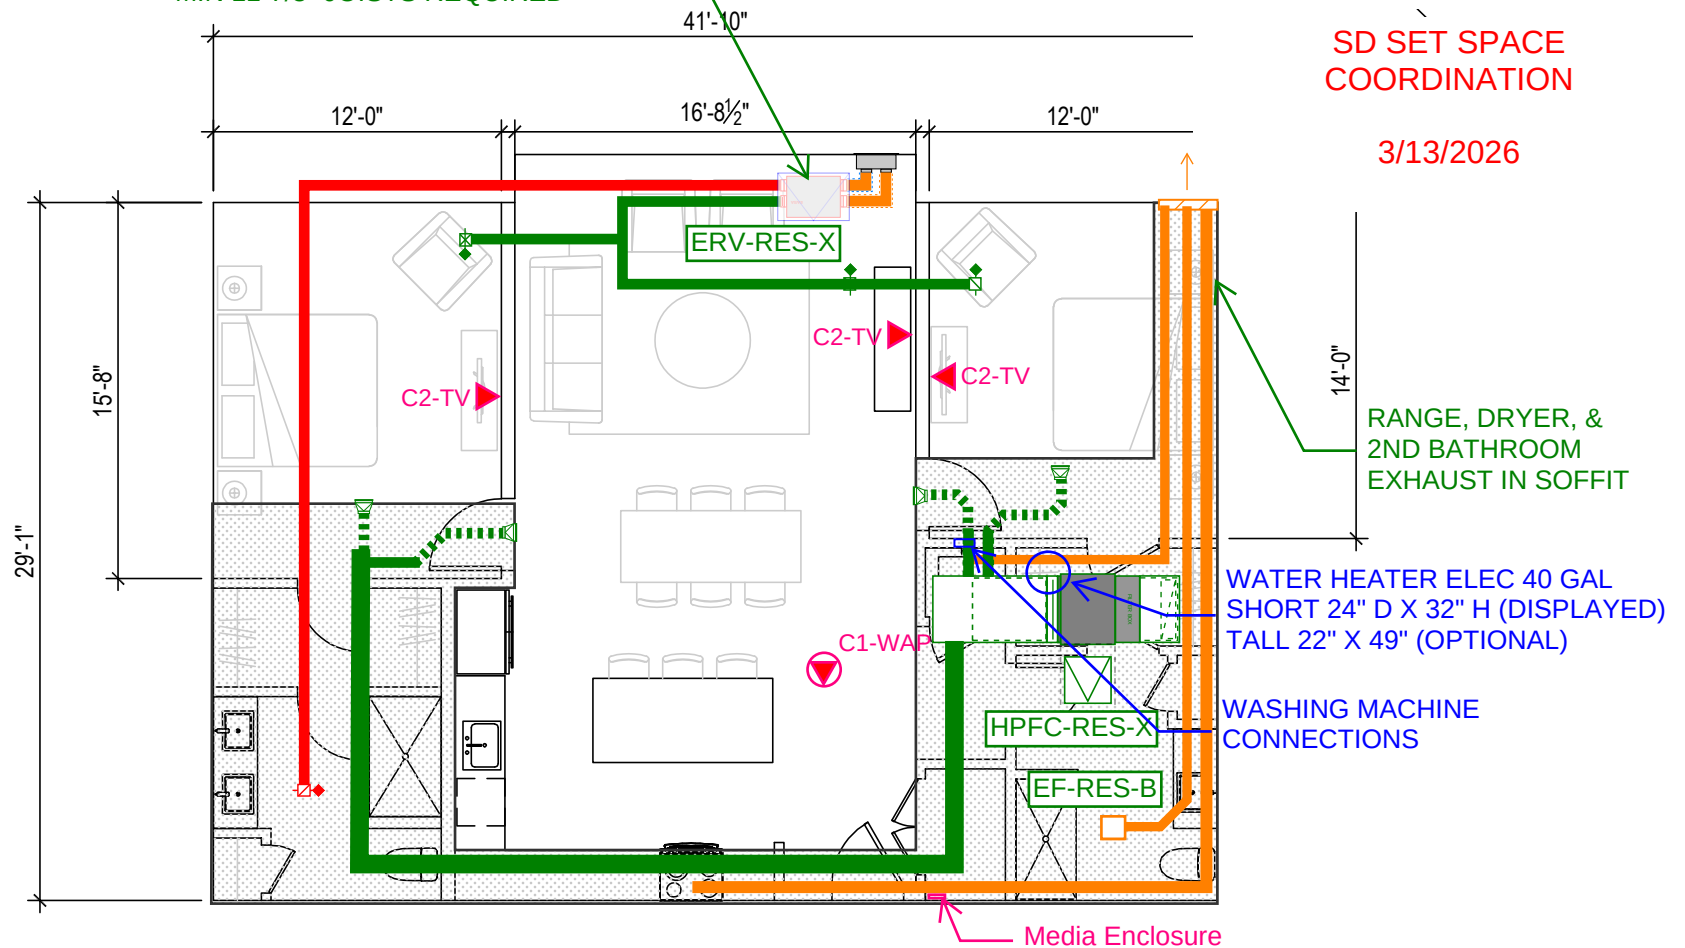

CONDO TYPICAL 2-BEDROOM

SCALE = 1/8" = 1'-0"

HVAC DUCTWORK LEGEND:

- SUPPLY DUCT
- ERV BATHROOM EXHAUST
- ENVIRONMENTAL EXHAUST
- INSULATED ERV OA INTAKE
- INSULATED ERV EXHAUST